


### LABOR AND MATERIALS

1	Copper	Connection	<u>3/4"</u>		\$	
	Lead					
1	Curb	Cock Valve	<u>3/4</u> in.		\$	
		T.S. & V.				
1	Service box	{ Short 3 1/2 x 4 1/2 Long 4 1/2 x 5 1/2 Buff or Rdway }			\$	
	Old returned					
27	Ft.	{ Copper G. I. C. I. }	<u>3/4</u> in.	Pipe at	\$	
	Nipples		in. at		\$	
	Bushings		to	in. at		\$
	Red'g	Coupl'gs		to	in. at	\$
	Inc'g					
	Union	in. at			\$	
	Meter	in. at			\$	
	Lead Joints	at			\$	
	Compound Joints	at			\$	
	Maintenance Foreman				\$	
	Hrs. Water Maint. Man-1	at			\$	
	Hrs. Water Maint. Man-2	at			\$	
	Hrs. Garage Foreman	at			\$	
	Hrs. Labor	at			\$	
	Hrs. Compressor	at			\$	
	Compensation Ins. at \$		per C		\$	
	Trucking				\$	
	Pav't Patch				\$	
	Tap by Gifford & Co.				\$	
					\$	
					\$	
	O'head				\$	
					\$	

St. \_\_\_\_\_  
Pl. \_\_\_\_\_  
Ave. No. 10

Name of Owner  
Rogers  
Mrs. Sam'l. Moses.

Labor and Mat'l. Report Sept. 19 1966

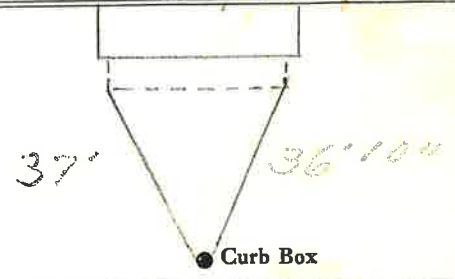

6" Main                      Elev. of Main at tap 4'

Gate at ●    ● Gate at

TAX ID # 303.18-15-12

● Curb Box

3/4" - 27' COPPER