


Labor and Materials

1	Copper	Connection	3/4"	\$ 2.70
1	Lead			
1	Curb	Cock Valve	3/4" in.	\$ 2.39
		T. S. & V.		
1	Service Box	Short 3/4" x 1/4"		\$ 1.55
	Old returned	Long 4 1/2" x 5 1/2"		
		Buff. or Rdway		
27	Ft.	3/4" in. Copper Galv. Iron Pipe at		\$ 7.29
		Cast Iron		
	Nipples	in. at		\$
	Bushings	to in. at		\$
	Red'g Inc'r	Couplings to in. at		\$
	Union	in. at		\$
	Meter	in. at		\$
	Lbs. Br. Stone	at		\$
	Lbs. Sand	at		\$
	Bags Cement	at		\$
	Paving Brick	Mack Red Asphalt at		\$
	Lead Joints	at		\$
	Leadite Joints	at		\$
2	Hrs. Foreman	at		\$ 1.25
8	Hrs. Common Labor	at Tapper		\$ 4.00
7	Hrs. Common Labor	at		\$ 3.15
	Hrs. Mason	at		\$
	Hrs. Mason's Helper	at		\$
	Hrs. Compressor	at		\$
	Compensation Ins.			\$.26
	Trucking			\$ 1.00
	Builders' Use of Water			\$ 5.00
Total \$				28.59

Labor and Material Report

3-30-1931

14 Rogers St.

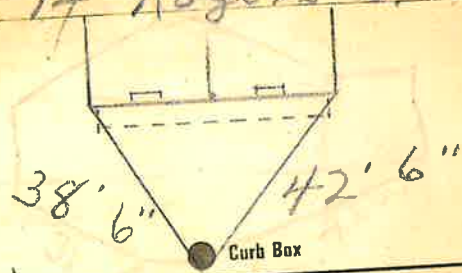

6 Main Elev of Main at tap 5
 Gate at ● Gate at ●

● Curb Box

TAX ID # 303.18-15-10

3/4" - 27' COPPER