

LABOR AND MATERIALS


1	Copper	Connection	3/4"	\$	2.76
1	Lead			\$	
1	Curb	Cock Valve	3/4" in.	\$	3.49
		T. S. & V.			
1	Service box	Short 3/4" X 4 1/2"		\$	4.74
	Old returned	Long 4 1/2" X 5 1/2"		\$	
		Buff or Rdway		\$	
34	Ft. 3/4 in.	Copper	Pipe at 38	\$	12.92
		G. I.			
		C. I.			
	Nipples	in. at		\$	
	Bushings	to in. at		\$	
	Red'g			\$	
	Inc'g	Coupl'gs to in. at		\$	
	Union	in. at		\$	
	Meter	in. at		\$	
	Lead Joints	at		\$	
	Compound Joints	at		\$	
	Hrs. Water Maint. Man	1 at		\$	
30	Hrs. Water Maint. Man	2 at	8.16	\$	4.77
3	Hrs. Labor	at	1.13	\$	3.39
	Hrs. Labor	at		\$	
	Hrs. Compressor	at		\$	
	Compensation Ins.	at \$4.40 per C		\$	36
	Trucking			\$	1.00
	Pav't Patch	outside		\$	
	Tap	June 1-33 by		\$	
		Leon Larcen & George		\$	
	O'head			\$	
				\$	33.43
				\$	3.78
				\$	29.65

9 ft billed

North-West Corner Broad Acres
 Road # 3553
 Roosevelt
 St.
 Pt.
 Ave. No. 16

Name of Owner
 Cowles

Labor and Mat'l. Report June 1 1953

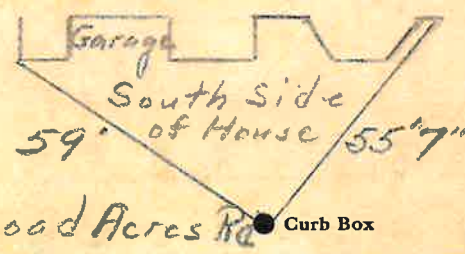

Roosevelt Ave

6" Main Elev. of Main at tap 5'

Gate at ● Gate at ●

TAX ID # 302.15-9-1

● Curb Box

3/4" - 34 Copper