

### Labor and Materials


1	Copper	} Connection $\frac{3}{4}$	\$2.60
	Lead		
1	Curb	} Cock Valve P-S & V. $\frac{3}{4}$ in.	\$2.30
1	Service Box	} Short $3\frac{1}{2} \times 4\frac{1}{2}$ Long $4\frac{1}{2} \times 5\frac{1}{2}$ Built or Redway	\$1.40
	Old returned		
26	Ft. $\frac{3}{4}$ " in.	} Copper Galv. Iron Cast Iron	\$6.89
	Nipples	in. at	\$
	Bushings	to in. at	\$
	Red'g Inc'g	} Couplings	to in. at \$
	Union		
	Meter	in. at \$	
	Lbs. Br. Stone	at \$	
	Lbs. Sand	at \$	
	Bags Cement	at \$	
	Paving Brick	} Mack Red Asphalt	at \$
	Lead Joints		
	Leadite Joints	at \$	
2	Hrs. Foreman	at \$1.25	
4	Hrs. Common Labor	at \$1.63	
	Hrs. Common Labor	at \$	
	Hrs. Mason	at \$	
	Hrs. Mason's Helper	at \$	
	Hrs. Compressor	at \$	
	Compensation Ins	\$0.8	
	Trucking	\$1.00	
	Builders' Use of Water	\$	
Total \$			17.15

29-137

Labor and Material Report

1929

22  
A Roosevelt Ave.

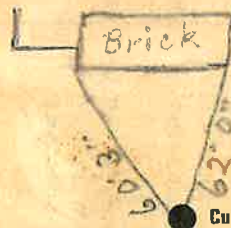

6 Main Pershing Rd. Elev of Main at tap  $3\frac{1}{2}$

Gate at TAX ID # 302.15-4-1 Gate at

Curb Box

Ethel K. Walker

$\frac{3}{4}$ " - 26' copper