

LABOR AND MATERIALS


1 Copper } 3/4" male Adapter
 Lead } Connection \$ _____
 1 Curb } Cock } 3/4" \$ _____
 } Valve }
 } T.S. & V. }
 1 Service box { Short 3 1/2 x 4 1/2 }
 - Old returned { Long 4 1/2 x 5 1/2 } \$ _____
 { Buff or Rdway }
 3 Ft. 3/4 in. { Copper } Pipe at \$ _____
 { G.I. }
 { C.I. }
 Nipples _____ in. at \$ _____
 Bushings _____ to _____ in. at \$ _____
 Red'g }
 Inc'g } Coupl'gs _____ to _____ in. at \$ _____
 Union _____ in. at \$ _____
 Meter _____ in. at \$ _____
 Lead Joints at \$ _____
 Compound Joints at \$ _____
 Maintenance Foreman \$ _____
 Hrs. Water Maint. Man—1 at \$ _____
 Hrs. Water Maint. Man—2 at \$ _____
 Hrs. Garage Foreman _____ at \$ _____
 Hrs. Labor— _____ at \$ _____
 Hrs. Compressor at \$ _____
 Compensation Ins. at \$ _____ per C \$ _____
 Trucking \$ _____
 Pav't Patch \$ _____
 Tap by Giggord & Co. 8-3-61 \$ _____
 O'head \$ _____

Hooked to 1" x 3/4 Brass
 Elbow on end of 1"
 Copper main.

Roosevelt St.
 Ave. No. 23

Name of Owner
 Charles Appleyard

Labor and Mat'l. Report Aug. 3 1961

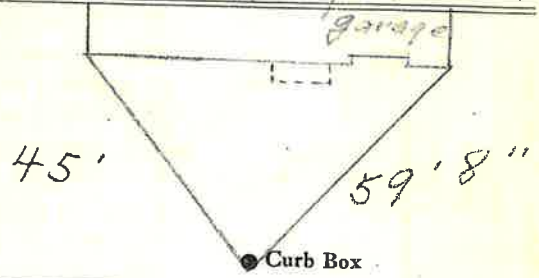

1" Copper Main Elev. of Main at tap 5'

Gate at • • Gate at

TAX ID # 302.15-5-6

• Curb Box
 1" Copper main
 between curb and
 sidewalk.

LSM-5C-3-10-61 3' copper