


LABOR AND MATERIALS

Hooked to 1" Tee Brass
 Copper } Connection \$ Swedge
 Lead }
 1 Curb } Cock } 3/4 in. \$
 } Valve }
 } T. S. & V. }
 1 Service box { Short 3 1/2 x 4 1/2 }
 Old returned { Long 4 1/2 x 5 1/2 } \$
 } Buff or Rdway }
 1' Ft. 1 in. { Copper } Pipe at \$
 } G.I. }
 } C.I. }
 Nipples in. at \$
 Bushings to in. at \$
 1 Red'g } Coupl'gs. / to 3/4 in. at \$
 Inc'g } sweat.
 Union in. at \$
 Meter in. at \$
 Lead Joints at \$
 Compound Joints at \$
 Maintenance Foreman \$
 Hrs. Water Maint. Man-1 at \$
 Hrs. Water Maint. Man-2 at \$
 Hrs. Garage Foreman at \$
 Hrs. Labor at \$
 Hrs. Compressor at \$
 Compensation Ins. at \$ per C \$
 Trucking \$
 Pav't Patch \$
 Tap by Giggard & Co. \$
 8-3-61 \$
 O'head \$

St. Roosevelt
 Pl. Ave. No. 25

Name of Owner
 Allan W. Ruggles

Labor and Mat'l. Report Aug 3 19 61

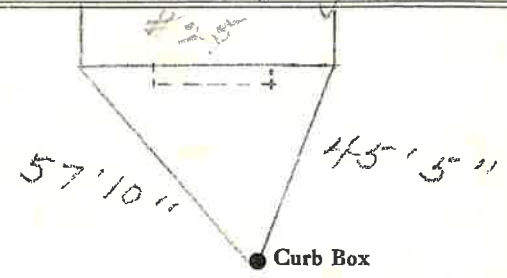

1" Copper Main Elev. of Main at tap 5'
 Gate at • Gate at

TAX ID # 302.15-5-5

• Curb Box
 1" Copper main between Curb & Side Walk.

1" copper