


LABOR AND MATERIALS

Copper	} Connection	_____	\$ _____	
Lead				
Curb	} Cock	_____ in.	\$ _____	
				} Valve
Service box	} Short 3 1/2 x 4 1/2	_____	\$ _____	
				Old returned
11 Ft. 3/4 in.	} Copper	} Pipe at _____	\$ _____	
				} G.I.
Nipples	_____ in. at _____	\$ _____		
Bushings	_____ to _____ in. at _____	\$ _____		
Red'g	} Coupl'gs _____ to _____ in. at _____	\$ _____		
Inc'g				
Union	_____ in. at _____	\$ _____		
Meter	_____ in. at _____	\$ _____		
_____		\$ _____		
Compound Joints	at _____	\$ _____		
Maintenance Foreman		\$ _____		
Hrs. Water Maint. Man-1	at _____	\$ _____		
Hrs. Water Maint. Man-2	at _____	\$ _____		
Hrs. Garage Foreman	at _____	\$ _____		
Hrs. Labor	at _____	\$ _____		
Hrs. Compressor	at _____	\$ _____		
_____		\$ _____		
Trucking		\$ _____		
Pav't Patch		\$ _____		
_____		\$ _____		
_____		\$ _____		
St. Dagamore
 Pl. _____
 Ave. No. 35

Name of Owner Jones

Labor and Mat'l. Report 1990

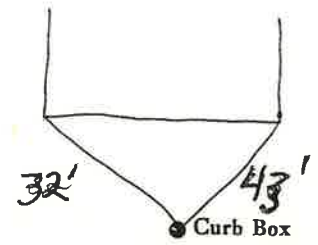

Main _____ Elev. of Main at tap 3'
 Gate at • _____ • Gate at _____

TAX-ID# 303.13-3-14

• Curb Box

11' to MAIN
 3/4" COPPER