


LABOR AND MATERIALS

Copper	} Connection		\$
Lead			
Curb	} Cock Valve	} in.	\$
Service box	} Short 3½ x 4½	}	\$
19 Ft.	} 1" in.	} Copper	\$
		} C. I.	
Nipples	in. at		
Bushings	to in. at		\$
Red'g	} Coupl'gs	to in. at	\$
Inc'g			
Union	in. at		\$
Meter	in. at		\$
			\$
Compound Joints	at		\$
Maintenance Foreman			\$
Hrs. Water Maint. Man-1	at		\$
Hrs. Water Maint. Man-2	at		\$
Hrs. Garage Foreman	at		\$
Hrs. Labor	at		\$
Hrs. Compressor	at		\$
			\$
Trucking			\$
Pav't Patch			\$
			\$
			\$
			\$
			\$

St. 36
~~Pl.~~
 Ave. No. 36

Name of Owner Sagamore
 TAX ID # 303.13-2-1

Labor and Mat'l. Report June 1972

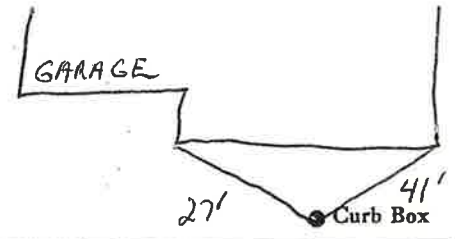

	Elev. of
Main	Main at tap
Gate at ●	● Gate at

19' to main ● Curb Box
 1" Tap to Box
 Reduced to 3/4" on Owner's side