


Labor and Materials

1	Copper	Connection	3/4	\$ 3.20
	Lead			
1	Curb	Cock Valve T. S. & V.	3 in.	\$ 1.00
1	Service Box	Short 3 1/2 x 4 1/2		\$ 1.40
	Old returned	Long 4 1/2 x 5 1/2		
8	Ft.	3/4 in. Copper Galv. Iron Cast Iron	Pipe at	\$ 1.76
	Nipples	in. at		\$
	Bushings	to in. at		\$
	Red'g Inc'g	Couplings to in. at		\$
	Union	in. at		\$
	Meter	in. at		\$
	Lbs. Br. Stone	at		\$
	Lbs. Sand	at		\$
	Bags Cement	at		\$
	Paving Brick	Mack Red Asphalt at		\$
	Lead Joints	at		\$
	Leadite Joints	at		\$
1	Hrs. Foreman	at		\$ .63
1	Hrs. Common Labor	at		\$ .41
	Hrs. Common Labor	at		\$
	Hrs. Mason	at		\$
	Hrs. Mason's Helper	at		\$
	Hrs. Compressor	at		\$
	Compensation Ins.			\$ .03
1	Trucking			\$ 1.00
	Builders' Use of Water			\$

dipping old conn - - - - - Total \$ 9.43  
 Full  
 2.10  
 11.53

Labor and Material Report

33 Sagamore St

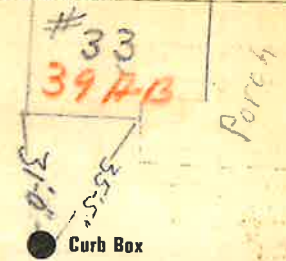

6" Main Elev. of Main at tap 4 1/2

Gate at TAX ID # 303.13-3-13 Gate at

Curb Box


old con. to be dug up  
 8' to MAIN  
 3/4" Copper

**Labor and Materials**

1	Copper } Connection	3/4	\$ 3.20
1	Curb } Cock	3/4 in.	\$ 1.00
		T.S. & V.	
1	Service Box } Old returned	Long 4 1/2 x 5 1/2 Ruff or Relay	\$ 1.40
7	Ft. } 3/4 in. } Copper } Galv. Iron } Cast Iron } Pipe at		\$ 1.54
	Nipples	in. at	\$
	Bushings	to in. at	\$
	Red'g } Inc'g } Couplings	to in. at	\$
	Union	in. at	\$
	Meter	in. at	\$
	Lbs. Br. Stone	at	\$
	Lbs. Sand	at	\$
	Bags Cement	at	\$
	Paving Brick } Mack } Red } Asphalt }	at	\$
	Lead Joints	at	\$
	Lead Joints	at	\$
2	Hrs. Foreman	at	\$ 1.25
	Hrs. Common Labor	at	\$
	Hrs. Common Labor	at	\$
	Hrs. Mason	at	\$
	Hrs. Mason's Helper	at	\$
	Hrs. Compressor	at	\$
	Compensation Ins.		\$ .03
1	Trucking		\$ 1.00
	Builders' Use of Water		\$
Total			\$ 9.42

27-110 Labor and Material Report July 7 19 27

39 Sycamore St.

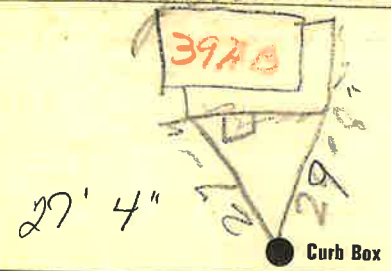

6 Main Elev. of Main at tap 5  
Gate at ● Gate at ●

● Curb Box

Old tap dis connected.

7' to main  
3/4" copper