


Labor and Materials

Lead	Copper	Connection	3/4"	\$1.50
27'	Curb	Cock Valve	3/4"	\$1.70
	Service Box	Short 3 1/2 x 4 1/2		\$1.44
	Returned	Long 4 1/2 x 5 1/2		
		Buff. or Liner		
27'	Ft.	Copper Galv. Iron Cast Iron	Pipe at	\$5.13
	Nipples	in. at		\$
	Bushings	to in. at		\$
	Red'g Inc'g	Couplings	to in. at	\$
	Union	in. at		\$
	Meter	in. at		\$
	Lbs. Br. Stone	at		\$
	Lbs. Sand	at		\$
	Bags Cement	at		\$
	Paving Brick	Mack Red Asphalt	at	\$
	Lead Joints	at		\$
	Leadite Joints	at		\$
17	Hrs.	Foreman	6.75	\$7.50
8	Hrs.	Common Labor	50	\$4.00
17	Hrs.	Common Labor	45	\$5.40
	Hrs.	Mason		\$
	Hrs.	Masons Helper		\$
	Hrs.	Compressor		\$
	Compensation Ins			\$2.61
	Trucking			\$2.00
	Builders Use of Water	Pay. P. Rate		\$3.50
Total				\$31.78

34 Sagamore St

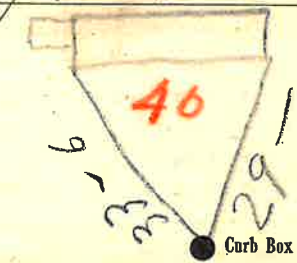

6 Main Elev. of Main at tap 3

Gate at TAX ID # 303.13-2-2 Gate at

● Curb Box

New House

27' to main
3/4" copper

[Handwritten signature]