

LABOR AND MATERIALS

1	Copper Lead	{ Connection $\frac{3}{4}$	in.	\$ 1.23	
1	Curb	{ Cock Valve T-S-&V.	{ copper to copper in.	\$ 1.68	
	Service Box Old returned	{ Short $3\frac{1}{2} \times 4\frac{1}{2}$ Long $4\frac{1}{2} \times 5\frac{1}{2}$ Buff. or Rdway		\$ 1.75	
9	Ft. $\frac{3}{4}$ in.	{ Copper Galv Iron Cast Iron	Pipe at	15 \$ 1.35	
	Nipples	in. at		\$	
	Bushings	to in. at		\$	
	Red'g Inc'g	{ Couplings	to in. at	\$	
	Union	in. at		\$	
	Meter	in. at		\$	
	Lead Joints	at		\$	
	Leadite Joints	at		\$	
	Hrs. Foreman	at		\$	
3	Hrs. Chauffeur	at	62 hr	\$ 1.88	
1	Hrs. Tapper	at		\$.62	
8	Hrs. Labor	at		\$ 3.60	
	Hrs. Labor	at		\$	
1	Hrs. Compressor	at	8 hr	\$.88	
	Compensation Ins.			\$.19	
	Trucking			\$ 1.00	
	Builders Use of Water	Patch		\$ 5.00	
	Tap by Miller			\$	
				\$	
				\$	
				\$	
				\$ 19.08	


102 -

Sagmore

St. **41**
Pt. **37**
Ave. No. **37**

Name of Owner

Labor and Mat'l. Report aug 30 1938

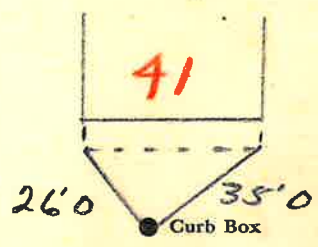

6" Main Elev. of Main at tap 4'

Gate at ● ● Gate at

TAX ID # 303.13-3-12

● Curb Box

old shut off
9' to main
3/4" copper