

Labor and Materials


Copper	Connection	3	\$1.33
Lead			
Curb	Cock Valve	1	\$1.58
	TS&V	1	
Service Box	Short 3 1/2 x 4 1/2		\$1.36
Old returned	Long 4 1/2 x 5 1/2		
	Def. on rdw.		
28 Ft.	Copper Cast Iron Pipe at	3/4	\$2.66
Nipples	in. at		\$
Bushings	to in. at		\$
Red'g Inc'g	Couplings to in. at		\$
Union	in. at		\$
Meter	in. at		\$
Lbs. Br. Stone	at		\$
Lbs. Sand	at		\$
Bags Cement	at		\$
Paving Brick	Mack Red Asphalt at		\$
Lead Joints	at		\$
Leadite Joints	at		\$
2 1/8 Hrs.	Foreman at		\$1.75
Hrs.	Common Labor at		\$3.60
Hrs.	Common Labor at		\$
Hrs.	Mason at		\$
Hrs.	Masons Helper at		\$
Hrs.	Compressor at		\$
Compensation Ins			\$1.15
Trucking			\$1.00
Builders Use of Water	Patch		\$2.50
Total			\$15.43

23-25

42

Labor and Material Report May 18 1933

34 Sagamore St & Sewer

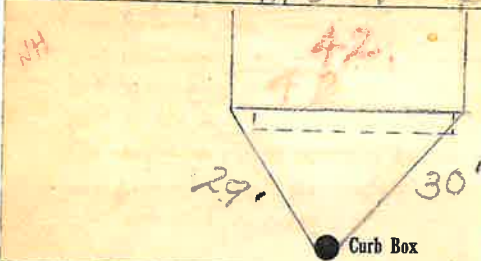

6 Main

Elev. of Main at tap 4

Gate at TAX ID # 303.13-2-3 Gate at

● Curb Box

New House
Water & Sewer
Shuts off
to the West

(Signature)

28' to main
3/4" copper