

LABOR AND MATERIALS

Copper	}	Connection			\$
Lead					
Curb	}	Cock	} in.		
		Valve			
		T. S. & V.			
1 Service box	}	Short 3½ x 4½	} \$		
Old returned		Long 4½ x 5½			
		Buff or Rdway			
Ft.	}	Copper	} Pipe at	?	
in.		G. I.			
		C. I.			
Nipples		in. at			\$
Bushings		to in. at			\$
Red'g	}	Coupl'gs	to in. at		
Inc'g					
Union		in. at			\$
Meter		in. at			\$
Lead Joints		at			\$
Compound Joints		at			\$
Maintenance Foreman					\$
Hrs. Water Maint. Man-1		at			\$
Hrs. Water Maint. Man-2		at			\$
Hrs. Garage Foreman		at			\$
Hrs. Labor		at			\$
Hrs. Compressor		at			\$
Compensation Ins. at \$		per C			\$
Trucking					\$
Pav't Patch					\$
<i>measured in</i>					
<i>by Giffard & Co.</i>					
<i>5-27-63.</i>					
O'head					\$

St.
-Pl. Sagamore
Ave. No. 43


Name of Owner

Newton

Measured in 5-27-63

Labor and Mat'l. Report

19

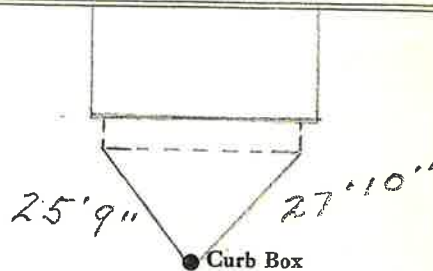

6" Main

Elev. of
Main at tap 5'

Gate at ●

● Gate at

TAX ID # 303.13-3-11

● Curb Box