

LABOR AND MATERIALS


$\frac{3}{4}$ " Copper } Connection _____ \$
 Curb } Cock }
 Valve }
 T.S. & V. } _____ in. _____ \$
 Service box { Short 3-1/2 x 4-1/2 } _____ \$
 Old returned { Long 4-1/2 x 5-1/2 }
 7' Ft. _____ in. { Copper } Pipe at _____ \$
 Nipples _____ in. at _____ \$

45 SAGAMORE

4 1/2' water main

7' - copper

24' 3" - SEWER
to curb stop

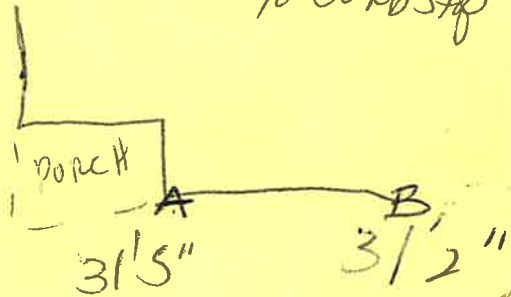

SAGA MORE

St.

Age No.


45

Name of Owner

TAX ID # 303.13-3-10.2

Labor and Mat'l. Report

4/2008

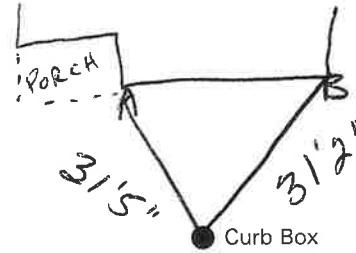

6" Main

Elev. of Main at tap

4 1/2'

Gate at ●

● Gate at

3/4" copper - 7' copper to main

● Curb Box

HAD OUTSIDE CLEAN-OUT

SEWER MAIN 24' 3"

From curb box