

**Labor and Materials**


1	Copper	Lead	Connection	2 1/4		\$ 3.20
1	Curb	Cock Valve	3/4 in.			\$ 10.00
1	Service Box	Old returned	Short 3 1/2 x 4 1/2 Long 4 1/2 x 5 1/2 Buff. or Rdway			\$ 1.40
33	Ft.	3/4 in.	Copper Galv. Iron Cast Iron	Pipe at		\$ 2.70
	Nipples			in. at		\$
	Bushings			to in. at		\$
1	Red g Inc g	Couplings	3/4	to in. at		\$ 1.00
	Union			in. at		\$
	Meter			in. at		\$
	Lbs. Br. Stone	at				\$
	Lbs. Sand	at				\$
	Bags Cement	at				\$
	Paving Brick	(Mack Red Asphalt)		at		\$
	Lead Joints	at				\$
	Leadite Joints	at				\$
2	Hrs. Foreman	at				\$ 1.25
2	Hrs. Common Labor	at				\$ 1.00
4	Hrs. Common Labor	at				\$ 1.63
	Hrs. Mason	at				\$
	Hrs. Mason's Helper	at				\$
	Hrs. Compressor	at				\$
	Compensation Ins.					\$ 1.00
	Trucking					\$ 1.00
	Builders' Use of Water					\$
Total						\$ 18.38

**Labor and Material Report**

19 28

46

MS 40 Bayan 2-27

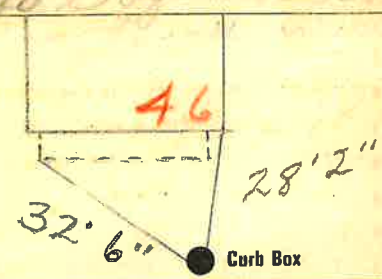

6" Main Elev. of Main at tap 5'  
Gate at TAX ID # 303.13-2-5 Gate at

● Curb Box

33' to main  
3/4" copper