

Labor and Materials

Copper } Connection.....	$\frac{3}{4}$	\$ 3.28
Curb } Cock Valve } T.S. & V. } in.....	$\frac{3}{4}$	\$ 1.00
Service Box } Standard } Long 4 1/2 x 5 1/2 } Standard } Rdway }		\$ 1.40
9 Ft. } $\frac{3}{4}$ in. } Copper } Pipe at.....		\$ 1.98
Nipples.....	in. at.....	\$
Bushings.....	to..... in. at.....	\$
Red'g } Inc'g } Couplings.....	to..... in. at.....	\$
Union.....	in. at.....	\$
Meter.....	in. at.....	\$
Lbs. Br. Stone at.....		\$
Lbs. Sand at.....		\$
Bags Cement at.....		\$
Paving Brick } Mack } Red } Asphalt } at.....		\$
Lead Joints at.....		\$
Leadite Joints at.....		\$
3 Hrs. Foreman at.....	6.25	\$ 1.87
Hrs. Common Labor at.....		\$
7 Hrs. Common Labor at.....	4.07	\$ 2.84
Hrs. Mason at.....		\$
Hrs. Mason's Helper at.....		\$
Hrs. Compressor at.....		\$
Compensation Ins.....		\$ 1.12
Trucking.....		\$ 1.50
Builders' Use of Water.....		\$
Total \$		13.41


27-44

45-47

Labor and Material Report

May 16 1927

41 *approximate*

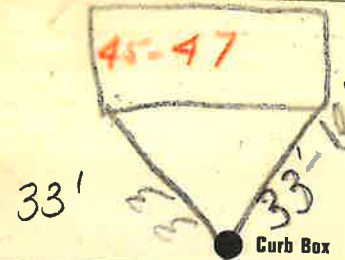

6 Main

Elev. of Main at tap 46

Gate at ●

● Gate at

● Curb Box

TAX ID# 303.13-3-10.1

9' to MAIN

3/4" COPPER