

LABOR AND MATERIALS

1	Copper Lead	Connection	3/4	\$	1.79
1	Curb	Clock Valve	3/4 in.	\$	2.61
1	Service box	Short 3/4x4 1/2 Long 4 1/2x5 1/2 Buff or Rdway		\$	1.82
	Old returned				
30	Ft.	Copper Galv. Iron Cast Iron	3/4 in.	Pipe at	23 \$ 6.90
	Nipples		in. at	\$	
	Bushings		to in. at	\$	
	Red'g Inc'g	Couplings	to in. at	\$	
	Union		in. at	\$	
	Meter		in. at	\$	
	Lead Joints		at	\$	
	Compound Joints		at	\$	
	Hrs. Foreman		at	\$	
12	Hrs. Chauffeur		at	\$	9.00
	Hrs. Tapper		at	\$	
12	Hrs. Labor		at	\$	7.80
	Hrs. Labor		at	\$	
	Hrs. Compressor		at	\$	
	Compensation Ins.			\$	46
	Trucking			\$	1.00
	Builders Use of Water			\$	5.00
	Tap by <i>Warrins...</i>				
				\$	
				\$	
				\$	
				\$	
				\$	36.39

0891


47, 46

St. 18  
Pl. 42  
Ave. No.

Sagamore

Name of Owner  
McCarthy

Labor and Mat'l. Report June 28 1946

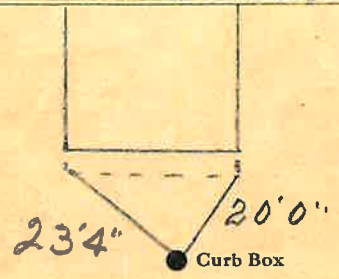

6 Main

Elev. of Main at tap 5

Gate at ● Gate at ●

TAX ID# 303.13-2-6

● Curb Box

30' to main  
3/4" Copper