

Labor and Materials

1	Copper } Connection $\frac{3}{4}$	\$ 3.20
	Lead	
1	Curb { Cock } $\frac{3}{4}$ in.	\$ 1.00
	{ Valve }	
	{ T. S. & V. }	
1	Service Box { Short 3 $\frac{1}{2}$ x 4 $\frac{1}{2}$ }	\$ 1.30
	Old returned { Long 4 $\frac{1}{2}$ x 5 $\frac{1}{2}$ }	
	{ Buff. or Rdway }	
9	Ft. $\frac{1}{2}$ in. { Copper } Pipe at	\$ 1.94
	{ Galv. Iron }	
	{ Cast Iron }	
	Nipples..... in. at.....	\$
	Bushings..... to..... in. at.....	\$
	Red'g } Couplings..... to..... in. at.....	\$
	Inc'g }	
	Union..... in. at.....	\$
	Meter..... in. at.....	\$
	Lbs. Br. Stone at.....	\$
	Lbs. Sand at.....	\$
	Bags Cement at.....	\$
	Paving Brick { Mack } at.....	\$
	{ Red }	
	{ Asphalt }	
	Lead Joints at.....	\$
	Leadite Joints at.....	\$
3	Hrs. Foreman at.....	\$ 2.88
	Hrs. Common Labor at.....	\$
7	Hrs. Common Labor at..... $\frac{40}{8}$	\$ 2.84
	Hrs. Mason at.....	\$
	Hrs. Mason's Helper at.....	\$
	Hrs. Compressor at.....	\$
	Compensation Ins.....	\$ 1.13
	Trucking.....	\$ 1.00
	Builders' Use of Water.....	\$
Total		\$ 13.33

27-207


7

Labor and Material Report

Nov. 23

1927

3 Sugamore

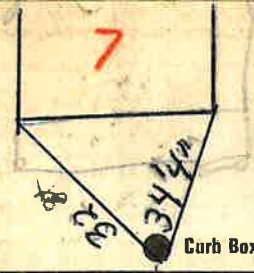

Main

Elev. of Main at tap

Gate at ●

● Gate at

● Curb Box

House to be razed
Shut off at Curb.
11-19-64,