


LABOR AND MATERIALS

1	Copper Lead	Connection	3/4"	\$	2.71
1	Curb	Cock Valve T.S. & V.	3/4 in.	\$	3.83
1	Service box	Short 3 1/2 x 4 1/2		\$	4.69
	Old returned	Long 4 1/2 x 5 1/2		\$	
		Buff or Rdway		\$	
30	Ft. 3/4 in.	Copper Pipe at	45	\$	13.50
		C.I.		\$	
		C.I.		\$	
	Nipples	in. at		\$	
	Bushings	to in. at		\$	
	Red'g Inc'g	Coupl'gs to in. at		\$	
	Union	in. at		\$	
	Meter	in. at		\$	
	Lead Joints	at		\$	
	Compound Joints	at		\$	
1	Maintenance Foreman			\$	1.51
	Hrs. Water Maint. Man-1	at		\$	
10	Hrs. Water Maint. Man-2	at	1.24	\$	12.40
	Hrs. Garage Foreman	at		\$	
20	Hrs. Labor	at	1.13	\$	22.60
	Hrs. Compressor	at		\$	
	Compensation Ins.	at \$ 4.29 per C		\$	1.57
	Trucking			\$	1.50
	Pay't Patch			\$	16.20
	Tap by Gifford	5-23-55		\$	
	O'head			\$	
				\$	80.54

St. Sagamore Ave. No. 50

Name of Owner Varney

Labor and Mat'l. Report May 23 1955

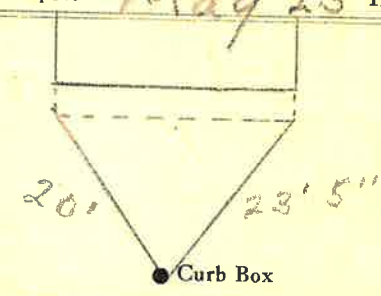

6" Main Elev. of Main at tap 5'

TAX ID # 303.13-2-7

● Curb Box  
 30' to main sewer TAP  
 3/4" copper in main hole  
 12/28/06