

Labor and Materials

1	Copper Lead	Connection	\$ 3.20
1	Curb	{ Cock Valve } { T. S. & V. }	{ 3/4 in. }	\$ 1.00
1	Service Box	{ Short 3 1/2 x 4 1/2 } { Old returned Long 4 1/2 x 5 1/2 }	{ } { Buff. or Rdway }	\$ 1.30
98	Ft. 3/4 in.	{ Copper Galv-Iron } { Cast-Iron }	Pipe at	\$ 3.96
	Nipples	in. at	\$
	Bushings	to..... in. at	\$
	Red'g Inc'g	Couplings to..... in. at	\$
	Union	in. at	\$
	Meter	in. at	\$
	Lbs. Br. Stone	at	\$
	Lbs. Sand	at	\$
	Bags Cement	at	\$
	Paving Brick	{ Mack Red Asphalt }	at	\$
	Lead Joints	at	\$
	Leadite Joints	at	\$
2	Hrs. Foreman	at	5.0	\$ 1.00
	Hrs. Common Labor	at	\$
1.2	Hrs. Common Labor	at	4.05%	\$ 4.87
	Hrs. Mason	at	\$
	Hrs. Mason's Helper	at	\$
	Hrs. Compressor	at	\$
	Compensation Ins.		\$ 1.7
	Trucking		\$ 1.00
	Builders' Use of Water		\$
Total				\$ 16.50

Labor and Material Report

1926

26-47 65
55 Sagamore St




Curb Box

6" Main

Elev. of Main at tap

Gate at TAX ID # 303.9-11-11 Gate at

Curb Box

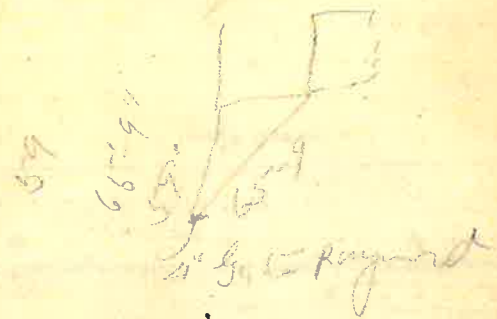

18' to main
3/4" copper