

### LABOR AND MATERIALS

Copper	} Connection	_____	\$	
Lead				
Curb	Cock Valve T. S. & V.	} in.	_____	\$
Service box	} Short 3½ x 4½ Long 4½ x 5½ Buff or Rdway	}	_____	\$
Old returned				
Ft.	} Copper G. I. C. I.	} Pipe at	_____	\$
Nipples	in.	at	_____	\$
Bushings	to	in.	_____	\$
Red'g	} Coupl'gs	} to	_____	\$
Inc'g			in.	at
Union	in.	at	_____	\$
Meter	in.	at	_____	\$
Lead Joints	at		_____	\$
Compound Joints	at		_____	\$
Maintenance Foreman			_____	\$
Hrs. Water Maint. Man—1	at		_____	\$
Hrs. Water Maint. Man—2	at		_____	\$
Hrs. Garage Foreman	at		_____	\$
Hrs. Labor—	at		_____	\$
Hrs. Compressor	at		_____	\$
Compensation Ins.	at \$	per C	_____	\$
Trucking			_____	\$
Pav't Patch			_____	\$
			_____	\$
			_____	\$
O'head			_____	\$
			_____	\$


St. 82  
 -Pt: 87  
 Ave. No. 87

Hogmore  
 Name of Owner \_\_\_\_\_

TAX ID # 303.9-6-1

---

Labor and Mat'l. Report 1987

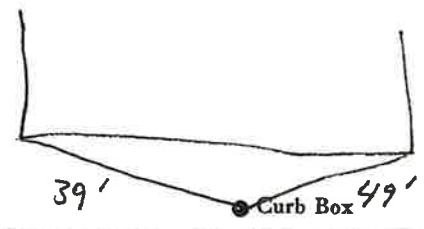

	Elev. of
Main	Main at tap
Gate at ●	● Gate at
● Curb Box	