

LABOR AND MATERIALS

1	Copper Lead	{ Connection	2"	\$10.95
1	Curb	{ Cock Valve I. S. & V.	2" in.	\$10.67
1	Service Box Old returned	{ Short 3 1/2 x 4 1/2 Long 4 1/2 x 5 1/2 Buff. or Rdway		\$ n.c.
30	Ft. 2" in.	{ Copper Galv Iron Cast Iron	Pipe at 45	\$13.50
	Nipples	in. at		\$
	Bushings	to in. at		\$
1	Redg Leadg	{ Couplings C to C	2 in. at	\$ 3.87
	Union	in. at		\$
	Meter	in. at		\$
	Lead Joints at			\$
	Leadite Joints at			\$
	Hrs. Foreman at			\$
8	Hrs. Chauffeur at	6 1/2		\$ 5.00
10	Hrs. Tapper at	-		\$ 6.25
15	Hrs. Labor at	45		\$ 6.75
	Hrs. Labor at			\$
2	Hrs. Compressor at	8 1/2		\$ 1.75
	Compensation Ins.			\$.55
	Trucking	50		\$ 3.00
	Builders Use of Water	Patch		\$ 5.00
	Tape & Miller			\$
	D.H. + Supervision			\$ 5.00
				\$
				\$
				\$ 72.29

158 - 1938


St. 1018
Pt.
Ave. No. 618

Name of Owner

National Bread Co.

Labor and Mat'l. Report

Aug 13 1938

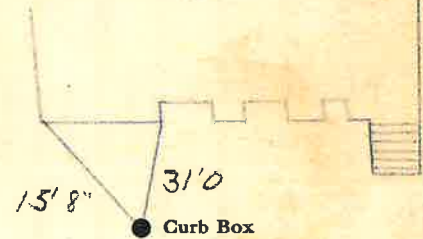

6 Main

Elev. of
Main at tap 5

Gate at ●

● Gate at

#10-#12 TAX ID# 303.13-8-7.1

● Curb Box

old shut off
30' to main
2" COPPER