

### LABOR AND MATERIALS


Copper Connection 1" \$ \_\_\_\_\_  
 Lead }  
 1" Curb } Cock } \_\_\_\_\_ in. \$ \_\_\_\_\_  
 Valve }  
 T.S. & V. }  
 Service box { Short 3-1/2 x 4-1/2 } \$ \_\_\_\_\_  
 Old returned { Long 4-1/2 x 5-1/2 } \$ \_\_\_\_\_  
 24 Ft. in. { Copper } Pipe at \$ \_\_\_\_\_  
 { G.I. }  
 { C.I. }  
 Nipples \_\_\_\_\_ in. at \$ \_\_\_\_\_  
 Bushings \_\_\_\_\_ to \_\_\_\_\_ in. at \$ \_\_\_\_\_  
 Red'g \_\_\_\_\_  
 Inc'g \_\_\_\_\_  
 Union \_\_\_\_\_ in. at \$ \_\_\_\_\_  
 Meter \_\_\_\_\_ in. at \$ \_\_\_\_\_  
 \_\_\_\_\_ \$ \_\_\_\_\_  
 Compound Joints at \$ \_\_\_\_\_  
 Maintenance Foreman \$ \_\_\_\_\_  
 Hrs. Water Maint. Man - 1 at \$ \_\_\_\_\_  
 Hrs. Water Maint. Man - 2 at \$ \_\_\_\_\_  
 Hrs. Garage Foreman \_\_\_\_\_ at \$ \_\_\_\_\_  
 Hrs. Labor \_\_\_\_\_ at \$ \_\_\_\_\_  
 Hrs. Compressor at \$ \_\_\_\_\_  
 \_\_\_\_\_ \$ \_\_\_\_\_  
 Trucking \$ \_\_\_\_\_  
 Pav't Patch \$ \_\_\_\_\_  
 \_\_\_\_\_ \$ \_\_\_\_\_  
 \_\_\_\_\_ \$ \_\_\_\_\_  
St. Sagamore  
 Pl. Ave. No. 108

Name of Owner

Waysey

Labor and Mat'l. Report 2/4 2005

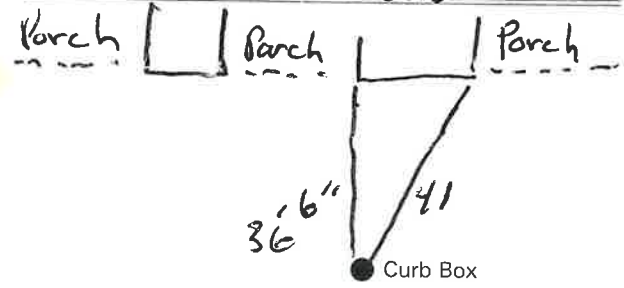

5' 3" Main Elev. of Main at tap 5' 2"

Gate at ● #110 ● Gate at

TAX ID # 303.9-6-3

● Curb Box

1" copper