

### LABOR AND MATERIALS

1	Copper	{ Connection	3/4	\$ 2.29	
	Lead				
1	Curb	{ Cock Valve	3/4 in.	\$ 2.70	
		T.S. & V.			
1	Service box	{ Short 3 1/2 x 4 1/2			
	Old returned	Long 4 1/2 x 5 1/2		\$ 4.25	
		Buff or Rdway			
10	Ft. 3/4 in.	{ Copper	Pipe at 35	\$ 3.50	
		G.I.			
		C.I.			
	Nipples	in. at		\$	
	Bushings	to in. at		\$	
	Red'g	{ Coupl'gs	to in. at	\$	
	Inc'g				
	Union	in. at		\$	
	Meter	in. at		\$	
	Lead Joints	at		\$	
	Compound Joints	at		\$	
	Hrs. Water Maint. Man—1	at		\$	
5	Hrs. Water Maint. Man—2	at	1.02	\$ 5.10	
12	Hrs. Labor—	at	.91	\$ 10.92	
	Hrs. Labor—	at		\$	
2	Hrs. Compressor	at	1.20	\$ 2.40	
	Compensation Ins. at \$	per C.		\$ 36	
	Trucking			\$	
	Pav't Patch			\$ 5.40	
	Tap by Mogerman			\$	
	O'head			\$	
				\$ 37.92	


LSM-5C

St.  
Pl.  
Ave. No. 13

Sagamore

Name of Owner  
Buschley

Labor and Mat'l. Report Apr 27 1950

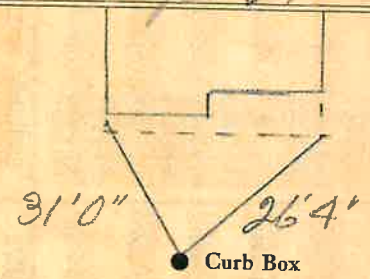

4 Main

Elev. of Main at tap 5

Gate at ● Gate at ●

TAX ID # 303.13-9-20

● Curb Box

10' to main  
3/4" copper

LSM-5C 10-21-49