

LABOR AND MATERIALS


Copper } Connection	_____	\$ _____
Lead } T.S. & V. }	_____ in.	\$ _____
Curb } Cock Valve }	_____ in.	\$ _____
Service box } Short 3 1/2 x 4 1/2 }	_____	\$ _____
Old returned } Long 4 1/2 x 5 1/2 }	_____	\$ _____
_____ } Buff or Rdway }	_____	\$ _____
16 Ft. 3/4 in. } Copper }	_____ Pipe at	\$ _____
_____ } G.I. }		
_____ } G.I. }		
Nipples _____ in. at	_____	\$ _____
Bushings _____ to _____ in. at	_____	\$ _____
Red'g } Coupl'gs _____ to _____ in. at	_____	\$ _____
Inc'g }		
Union _____ in. at	_____	\$ _____
Meter _____ in. at	_____	\$ _____
Lead Joints at	_____	\$ _____
Compound Joints at	_____	\$ _____
Maintenance Foreman _____	_____	\$ _____
Hrs. Water Maint. Man-1 at	_____	\$ _____
Hrs. Water Maint. Man-2 at	_____	\$ _____
Hrs. Garage Foreman _____ at	_____	\$ _____
Hrs. Labor _____ at	_____	\$ _____
Hrs. Compressor at	_____	\$ _____
Compensation Ins. at \$ _____ per C	_____	\$ _____
Trucking _____	_____	\$ _____
Pav't Patch _____	_____	\$ _____
_____	_____	\$ _____
_____	_____	\$ _____
_____	_____	\$ _____
O'head _____	_____	\$ _____
_____	_____	\$ _____

St. _____
-Pl. _____
Ave. No. 15

SAGAMORE

Name of Owner
(RENEWAL) Herbert C. [Signature]

Labor and Mat'l. Report 19

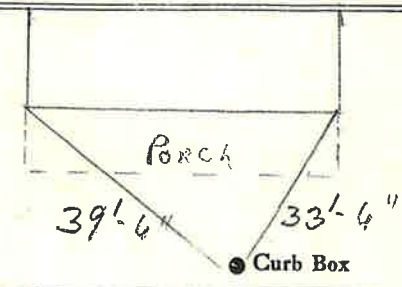

8" Main Elev. of Main at tap 5'

Gate at • Gate at •

TAX ID# 303.13-9-19

• Curb Box

16' to MAIN
3/4" COPPER