

# LABOR AND MATERIALS


     Copper } Connection \_\_\_\_\_ \$  
     Lead }  
     Curb } Cock \_\_\_\_\_ in. \_\_\_\_\_ \$  
         } Valve }  
         } T.S. & V. }  
     Service box { Short 3-1/2 x 4-1/2 } \_\_\_\_\_ \$  
     Old returned { Long 4-1/2 x 5-1/2 }  
11 Ft. \_\_\_\_\_ in. { Copper } Pipe at \_\_\_\_\_ \$  
                        } G.I. }  
                        } C.I. }  
     Nipples \_\_\_\_\_ in. at \_\_\_\_\_ \$  
     Bushings \_\_\_\_\_ to \_\_\_\_\_ in. at \_\_\_\_\_ \$  
     Red'g \_\_\_\_\_  
     Inc'g \_\_\_\_\_  
     Union \_\_\_\_\_ in. at \_\_\_\_\_ \$  
     Meter \_\_\_\_\_ in. at \_\_\_\_\_ \$  
     \_\_\_\_\_ \$  
     Compound Joints at \_\_\_\_\_ \$  
     Maintenance Foreman \_\_\_\_\_ \$  
     Hrs. Water Maint. Man - 1 at \_\_\_\_\_ \$  
     Hrs. Water Maint. Man - 2 at \_\_\_\_\_ \$  
     Hrs. Garage Foreman \_\_\_\_\_ at \_\_\_\_\_ \$  
     Hrs. Labor \_\_\_\_\_ at \_\_\_\_\_ \$  
     Hrs. Compressor at \_\_\_\_\_ \$  
     \_\_\_\_\_ \$  
     Trucking \_\_\_\_\_ \$  
     Pav't Patch \_\_\_\_\_ \$  
     \_\_\_\_\_ \$  
     \_\_\_\_\_ \$  
     \_\_\_\_\_ \$  
     \_\_\_\_\_ \$

#5 Sanford

St. Pl. Ave. No. 11

Name of Owner

Labor and Mat'l. Report # 2006-6/30

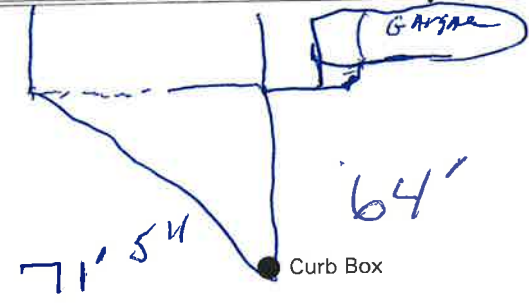

6" Main

Elev. of Main at tap 4'

Gate at ●

● Gate at

TAX ID # 302.16-10-7.1

● Curb Box

11' to main