


Sanford

St. ~~Pl.~~  
Ave. No. 33

Name of Owner

Measured in  
Labor and Mat'l. Report Oct. 29 1962

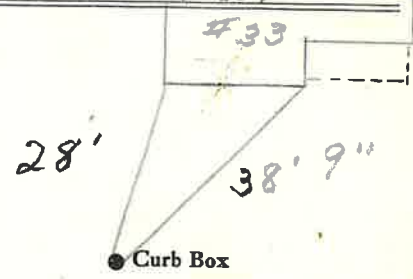

_____ Main	Elev. of Main at tap
Gate at ●	● Gate at

● Curb Box


SANFORD

St. 33  
Ave. No.

Name of Owner

MEASURED  
Labor and Mat'l. Report ~~28~~ JUNE 2002

A = 27' 3"  
B = 43' 6"

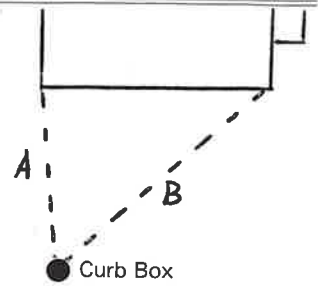

_____ Main	Elev. of Main at tap
Gate at ●	● Gate at

TAX ID # 302.16-11-13

● Curb Box



