

## LABOR AND MATERIALS


Copper } Lead }	Connection _____	\$ _____
Curb } Cock } Valve } T.S. & V. }	_____ in. _____	\$ _____
Service box } Old returned }	{ Short 3-1/2 x 4-1/2 } { Long 4-1/2 x 5-1/2 }	\$ _____
Ft. _____ in.	{ Copper } { G.I. } { C.I. }	Pipe at _____ \$ _____
Nipples _____	in. at _____	\$ _____
Bushings _____	to _____ in. at _____	\$ _____
Red'g _____		
Inc'g _____		
Union _____	in. at _____	\$ _____
Meter _____	in. at _____	\$ _____
_____		\$ _____
Compound Joints at _____		\$ _____
Maintenance Foreman _____		\$ _____
Hrs. Water Maint. Man - 1 at _____		\$ _____
Hrs. Water Maint. Man - 2 at _____		\$ _____
Hrs. Garage Foreman _____	at _____	\$ _____
Hrs. Labor _____	at _____	\$ _____
Hrs. Compressor at _____		\$ _____
_____		\$ _____
Trucking _____		\$ _____
Pav't Patch _____		\$ _____
_____		\$ _____
_____		\$ _____
SAN FORDS

St. \_\_\_\_\_  
Pl. \_\_\_\_\_  
Ave. No. 193

Name of Owner \_\_\_\_\_

Labor and Mat'l. Report 19

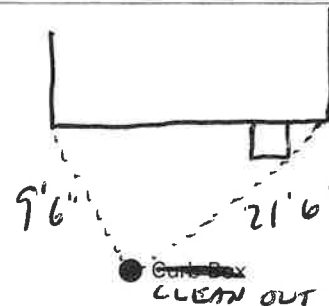

_____ Main	Elev. of Main at tap _____
Gate at ●	● Gate at
_____	
● Curb Box	