

LABOR AND MATERIALS

1	Copper	Lead	Connection	3/4	\$	3.87
1	Curb	Cock Valve	T. S. & V.	3/4 in.	\$	3.62
1	Service box	Old returned	Short 3 1/2 X 4 1/2		\$	4.68
26			Long 4 1/2 X 5 1/2		\$	
24			Buff or Rdway		\$	
24			Copper		\$	
			G. I.		\$	
			C. I.		\$	
			Pipe at	22	\$	7.68
	Nipples		in. at		\$	
	Bushings		to in. at		\$	
	Red'g				\$	
	Inc'g		Coupl'gs to in. at		\$	
	Union		in. at		\$	
	Meter		in. at		\$	
	Lead Joints		at		\$	
	Compound Joints		at		\$	
	Hrs. Water Maint. Man-1		at		\$	
3	Hrs. Water Maint. Man-2		at	1.02	\$	3.06
6	Hrs. Labor-		at	91	\$	5.46
	Hrs. Labor-		at		\$	
	Hrs. Compressor at				\$	
	Compensation Ins. at	\$ 2.18	per C.		\$	1.19
	Trucking				\$	2.09
	Pav't Patch				\$	10.28
	Tally by 11/27/49				\$	
	O'head				\$	
					\$	39.81

96


St.
Pl.
Ave. No. 195

Sanford

Name of Owner

Hubrey

Labor and Mat'l. Report Sept 21 1949

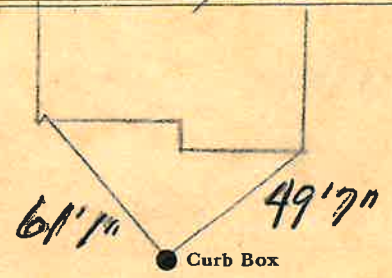

12" - 1953
6" Main

Elev. of Main at tap 3 1/2

Gate at ● Gate at ●

TAX ID # 303.9-15-1

● Curb Box

36' to main
3/4" copper