


196 SAN FORD Ave. No. 196

Name of Owner

Labor and Mat'l. Report

10/30/17

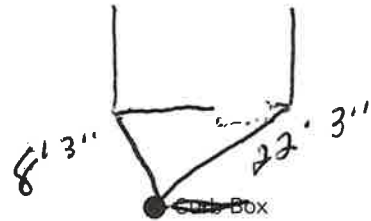

OUTSIDE CLEAN OUT

Main

Elev. of Main at tap

Gate at

Gate at

Curb Box

L 8' 3" R 22' 3"
OUTSIDE CLEAN OUT

TMM

1941

SANFORD


St. Ave. No. 196

Name of Owner

Cafaro

Labor and Mat'l. Report

Apr 11 1941

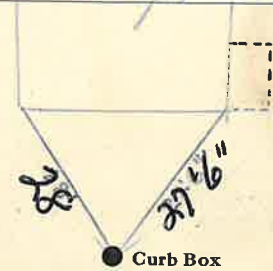

12-1953

Main

Elev. of Main at tap

4 1/2

Gate at

Gate at

TAX ID # 303.9-7-35.1

Curb Box

8' to main
3/4" copper

