


LABOR AND MATERIALS

1	Copper	} Connection	3/4"	\$	_____	
	<del>Lead</del>					
1	Curb	} Cock Valve T.S. & V.	} 3/4 in.	\$	_____	
1	Service box	} Short 3 1/2 x 4 1/2	}	\$	_____	
	<del>Old returned</del>					Long 4 1/2 x 5 1/2
						Buff or Rdway
22	Ft. 3/4 in.	} Copper	} Pipe at	\$	_____	
						G.I.
		G.I.				
	Nipples	in. at		\$	_____	
	Bushings	to	in. at	\$	_____	
	Red'g	} Coupl'gs	to	in. at	\$	
	Inc'g					
	Union	in. at		\$	_____	
	Meter	in. at		\$	_____	
	Lead Joints at			\$	_____	
	Compound Joints at			\$	_____	
	Maintenance Foreman			\$	_____	
	Hrs. Water Maint. Man	1 at		\$	_____	
	Hrs. Water Maint. Man	2 at		\$	_____	
	Hrs. Garage Foreman	at		\$	_____	
	Hrs. Labor	at		\$	_____	
	Hrs. Compressor at			\$	_____	
	Compensation Ins. at \$	per C		\$	_____	
	Trucking			\$	_____	
	Pav't Patch			\$	_____	
	Tap by Gifford & Co.			\$	_____	
	10-29-59.			\$	_____	
				\$	_____	
	O'head			\$	_____	
				\$	_____	

St. Sanford  
 Pl. \_\_\_\_\_  
 Ave. No. 199

Name of Owner Joseph Gokey

Labor and Mat'l. Report Oct 29 19 59

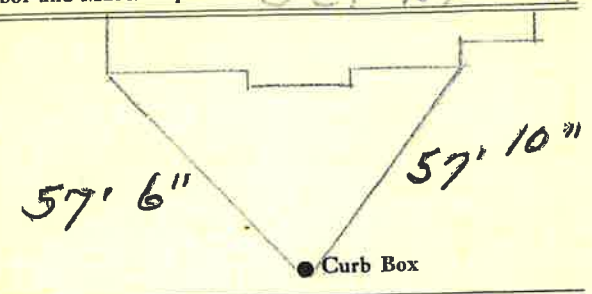

6" Main Elev. of Main at tap 4 1/2'

Gate at • Gate at

TAX ID # 303.9-16-6

• Curb Box  
 22' to main  
 3/4" copper