

LABOR AND MATERIALS

1 Copper Connection  $\frac{3}{4}$ " \$ \_\_\_\_\_

1 Curb Cock Valve  $\frac{3}{4}$  in. \$ \_\_\_\_\_

1 Service box Old returned { Short  $3\frac{1}{2} \times 2\frac{1}{2}$   
Long  $4\frac{1}{2} \times 5\frac{1}{2}$   
Back or Redway } \$ \_\_\_\_\_

23 Ft.  $\frac{3}{4}$  in. { Copper  
Gal. } Pipe at \$ \_\_\_\_\_

Nipples in. at \$ \_\_\_\_\_

Bushings to in. at \$ \_\_\_\_\_

Red'g } Coupl'gs to in. at \$ \_\_\_\_\_

Inc'g }

Union in. at \$ \_\_\_\_\_

Meter in. at \$ \_\_\_\_\_

Lead Joints at \$ \_\_\_\_\_

Compound Joints at \$ \_\_\_\_\_

Maintenance Foreman \$ \_\_\_\_\_

Hrs. Water Maint. Man-1 at \$ \_\_\_\_\_

Hrs. Water Maint. Man-2 at \$ \_\_\_\_\_

Hrs. Garage Foreman at \$ \_\_\_\_\_

Hrs. Labor at \$ \_\_\_\_\_

Hrs. Compressor at \$ \_\_\_\_\_

Compensation Ins. at \$ per C \$ \_\_\_\_\_

Trucking \$ \_\_\_\_\_

Pav't Patch \$ \_\_\_\_\_


Tap Made By Becker + Co \$ \_\_\_\_\_

O'head July-25-1974 \$ \_\_\_\_\_

SANFORD St. No. 201 Ave. No.

Name of Owner Wm. BANNON

Labor and Mat'l. Report July 18 1974

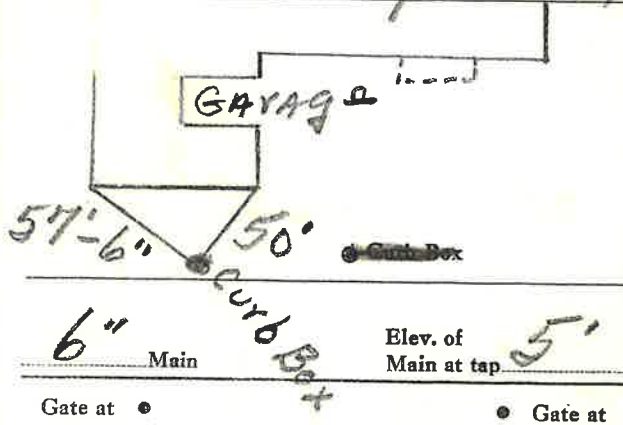

TAX ID # 303.9-16-5

23' to MAIN  
3/4" copper