

# LABOR AND MATERIALS

Copper	Connection	_____	\$	_____
Lead	Cock	_____	\$	_____
Curb	Valve	_____ in.	\$	_____
	T. S. & V.	_____	\$	_____
Service box	Old returned	Short $3\frac{1}{2} \times 4\frac{1}{2}$	}	_____ \$
		Long $4\frac{1}{2} \times 5\frac{1}{2}$		
Ft.	in.	Copper	} Pipe at	_____ \$
		G. I.		_____ \$
		C. I.		_____ \$
Nipples	in. at	_____	\$	_____
Bushings	to _____ in. at	_____	\$	_____
Red'g	} Coupl'gs	to _____ in. at	}	_____ \$
Inc'g		_____ in. at		_____ \$
Union	in. at	_____	\$	_____
Meter	in. at	_____	\$	_____
Lead Joints	at	_____	\$	_____
Compound Joints	at	_____	\$	_____
Maintenance Foreman		_____	\$	_____
Hrs. Water Maint. Man-1	at	_____	\$	_____
Hrs. Water Maint. Man-2	at	_____	\$	_____
Hrs. Garage Foreman	at	_____	\$	_____
Hrs. Labor	at	_____	\$	_____
Hrs. Compressor	at	_____	\$	_____
Compensation Ins. at \$	per C	_____	\$	_____
Trucking		_____	\$	_____
Pav't Patch		_____	\$	_____
		_____	\$	_____
		_____	\$	_____
O'head		_____	\$	_____

SANFORD


St. No. 203

Name of Owner

MEASURED IN

Labor and Mat'l. Report

MAY 12 1976

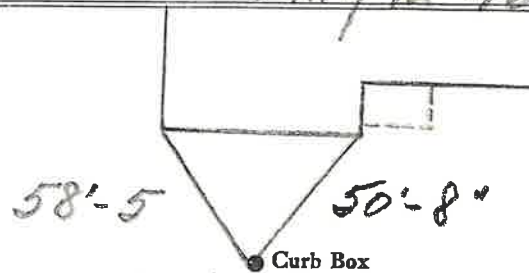

	Main	Elev. of Main at tap
Gate at	●	● Gate at
		● Curb Box