


LABOR AND MATERIALS

1	Copper Lead	Connection	$\frac{3}{4}$ "	\$	3.08
1	Curb	Cock Valve F.S.&V.	$\frac{3}{4}$ in.	\$	3.89
1	Service box Old returned	Short $3\frac{1}{2}$ x $4\frac{1}{2}$ Long $4\frac{1}{2}$ x $5\frac{1}{2}$ Buff or Rdway		\$	4.32
22	Ft. $\frac{3}{4}$ in.	Copper C.I. C.I.	Pipe at 45	\$	9.90
	Nipples	in. at		\$	
	Bushings	to in. at		\$	
	Red'g				
	Inc'g	Coupl'gs to in. at		\$	
	Union	in. at		\$	
	Meter	in. at		\$	
	Lead Joints	at		\$	
	Compound Joints	at		\$	
2	Maintenance Foreman			\$	3.87
	Hrs. Water Maint. Man-1	at		\$	$\frac{1}{2}$
	Hrs. Water Maint. Man-2	at		\$	$\frac{1}{2}$
	Hrs. Garage Foreman	at		\$	
4	Hrs. Labor	at		\$	16.85
16	Hrs. Compressor	Sch. Boy Lab.		\$	16.00
	Compensation Ins.	at \$5.86 per C.		\$	1.80
	Trucking			\$	1.50
	Pav't Patch			\$	
	Tap by Miller & Co.			\$	
				\$	
				\$	
	O'head			\$	
				\$	56.51

St. Sanford
~~Pl.~~
 Ave. No. 205

Name of Owner
 Cooper

Labor and Mat'l. Report July 20 19 56

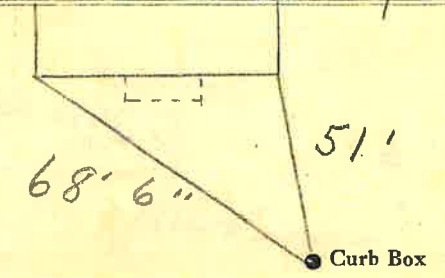

6" Main Elev. of Main at tap 4'
 Gate at • Gate at •

TAX ID # 303.9-16-4

• Curb Box
 22' to main
 3/4" copper