

### LABOR AND MATERIALS


Copper	} Connection									
Lead			\$							
Curb	} Cock Valve T. S. & V. }	} in.	\$							
Service box	} Short 3½ x 4½ Long 4½ x 5½ Buff or Rdway }		\$							
Old returned										
Ft. _____ in.	} Copper G. I. C. I. }	} Pipe at	\$							
Nipples _____ in.			\$							
Bushings _____ to _____ in.			\$							
Red'g } Inc'g }	} Coupl'gs _____ to _____ in.		\$							
Union _____ in.			\$							
Meter _____ in.			\$							
Lead Joints at _____			\$							
Compound Joints at _____			\$							
Maintenance Foreman _____			\$							
Hrs. Water Maint. Man—1 at _____			\$							
Hrs. Water Maint. Man—2 at _____			\$							
Hrs. Garage Foreman _____ at _____			\$							
Hrs. Labor— _____ at _____			\$							
Hrs. Compressor at _____			\$							
Compensation Ins. at \$ _____ per C			\$							
Trucking _____			\$							
Pav't Patch _____			\$							
			\$							
			\$							
			\$							
O'head _____			\$							
			\$							

SANFORD

St. \_\_\_\_\_  
Pt. \_\_\_\_\_  
Ave. No. 206

Name of Owner \_\_\_\_\_  
**TAX ID # 303.9-7-36**

*Measured in*  
Labor and Mat'l. Report MAY 12 1976

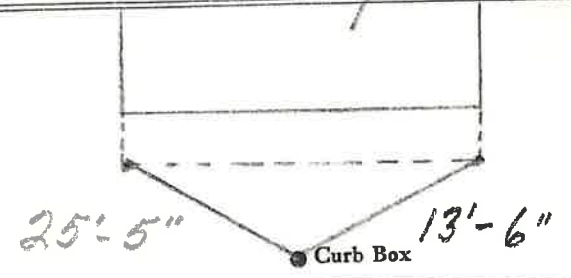

	Elev. of
Main	Main at tap
Gate at ●	● Gate at

● Curb Box