

LABOR AND MATERIALS

1	Copper	Connection	3/4	\$	2.87
	Lead				
1	Curb	Cock Valve	3/4 in.	\$	3.62
		T. S. & V.			
1	Service box	Short 3 1/2 X 4 1/2			4.68
	Old returned	Long 4 1/2 X 5 1/2			
		Buff or Rdway			
11	Ft.	3/4 in. Copper	Pipe at 32	\$	3.52
		G. I.			
		C. I.			
	Nipples	in. at		\$	
	Bushings	to in. at		\$	
	Red'g				
	Inc'g	Coupl'gs to in. at		\$	
	Union	in. at		\$	
	Meter	in. at		\$	
	Lead Joints at			\$	
	Compound Joints at			\$	
	Hrs. Water Maint. Man-1 at			\$	
10	Hrs. Water Maint. Man-2 at	1.02		\$	10.20
11	Hrs. Labor-	at 91		\$	10.01
	Hrs. Labor-	at		\$	
2	Hrs. Compressor at	1.20		\$	2.40
	Compensation Ins. at \$ 2.18 per C.			\$.44
	Trucking			\$	2.00
	Pav't Patch			\$	1.85
	Tax by Meter			\$	
	O'head			\$	
				\$	54.59

91

St.
Pl.
Ave. No. 34


Sanford

Name of Owner

Cleghorn

Labor and Mat'l. Report

Aug 25 1949

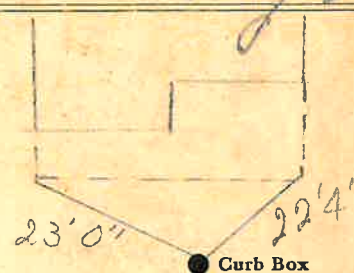

6 Main

Elev. of Main at tap 5-

Gate at ●

● Gate at

TAX ID # 302.16-5-3D

● Curb Box

11' to main
3/4" copper