


LABOR AND MATERIALS

1	Copper	Connection	3/4"	\$
1	Lead	Cock	3/4 in.	\$
1	Curb	Valve	3/4 in.	\$
		T. S. & V.		
1	Service box	Short 3 1/2 x 4 1/2		\$
	Old returned	Long 4 1/2 x 5 1/2		\$
		Buff or Rdway		\$
20	Ft. 3/4 in.	Copper	Pipe at	\$
		G. I.		\$
		G. I.		\$
	Nipples	in. at		\$
	Bushings	to in. at		\$
	Red'g			\$
	Inc'g	Coupl'gs to in. at		\$
	Union	in. at		\$
	Meter	in. at		\$
	Lead Joints	at		\$
	Compound Joints	at		\$
	Maintenance Foreman			\$
	Hrs. Water Maint. Man-1	at		\$
	Hrs. Water Maint. Man-2	at		\$
	Hrs. Garage Foreman	at		\$
	Hrs. Labor	at		\$
	Hrs. Compressor	at		\$
	Compensation Ins. at \$	per C		\$
	Trucking			\$
	Pav't Patch			\$
	Tape by G. I. S. Co.			\$
	April 26-62			\$
	O'head			\$
				\$

St. Sanford St.
 Pl. 209
 Ave. No. 209

Name of Owner Dr. O'Keefe

Labor and Mat'l. Report April 26 1962

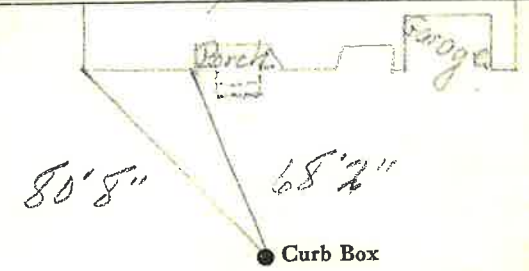

6" Main Elev. of Main at tap 4 to 5'
 Gate at • Gate at •

• Curb Box
 20' to MAIN
 3/4" COPPER