


LABOR AND MATERIALS

Copper	} Connection	_____	\$ _____	
Lead				
Curb	} Cock Valve T. S. & V. }	_____ in.	\$ _____	
		} Short 3½ x 4½ }		
			} Long 4½ x 5½ }	
Service box		_____	\$ _____	
Old returned			\$ _____	
14 Ft.	} Copper G.I. C.I. }	} Pipe at	\$ _____	
3/4 in.				
Nipples	_____ in. at		\$ _____	
Bushings	_____ to _____ in. at		\$ _____	
Red'g	} Coupl'gs	to _____ in. at	\$ _____	
Inc'g				
Union	_____ in. at		\$ _____	
Meter	_____ in. at		\$ _____	
			\$ _____	
Compound Joints	at		\$ _____	
Maintenance Foreman			\$ _____	
Hrs. Water Maint. Man—1	at		\$ _____	
Hrs. Water Maint. Man—2	at		\$ _____	
Hrs. Garage Foreman	at		\$ _____	
Hrs. Labor—	at		\$ _____	
Hrs. Compressor	at		\$ _____	
			\$ _____	
Trucking			\$ _____	
Pav't Patch			\$ _____	
			\$ _____	
			\$ _____	
			\$ _____	
			\$ _____	

St. Sanford
~~Pl.~~
 Ave. No. 212

Name of Owner
O'lick

Labor and Mat'l. Report 1970

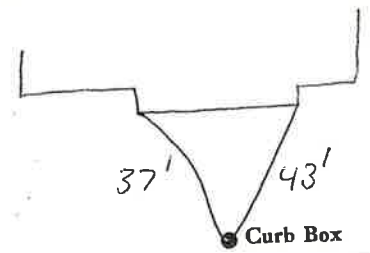

TAX ID # 303.9-7-39
 Elev. of
 Main at tap _____
 Main _____
 Gate at • _____ Gate at _____

• Curb Box
14' to main
3/4" COPPER