

### LABOR AND MATERIALS

<u>3/4</u>	Copper Lead } Connection	_____	\$ _____
	Curb } Cock Valve T.S. & V. }	_____ in. _____	\$ _____
	Service box { Short 3-1/2 x 4-1/2 } Old returned { Long 4-1/2 x 5-1/2 }	_____	\$ _____
<u>21</u>	Ft. _____ in. { Copper G.I. C.I. } Pipe at	_____	\$ _____
	Nipples _____ in. at	_____	\$ _____
	Bushings _____ to _____ in. at	_____	\$ _____
	Red'g _____		\$ _____
	Inc'g _____		\$ _____
	Union _____ in. at	_____	\$ _____
	Meter _____ in. at	_____	\$ _____
	Compound Joints at	_____	\$ _____
	Maintenance Foreman _____		\$ _____
	Hrs. Water Maint. Man - 1 at	_____	\$ _____
	Hrs. Water Maint. Man - 2 at	_____	\$ _____
	Hrs. Garage Foreman _____ at	_____	\$ _____
	Hrs. Labor _____ at	_____	\$ _____
	Hrs. Compressor at	_____	\$ _____
	Trucking _____		\$ _____
	Pav't Patch _____		\$ _____
			\$ _____
			\$ _____
221 Sanford

St.


Dr. O'Keffe

Pl. Ave. No. 221

Name of Owner

TAX ID # 303.9-18-6

Labor and Mat'l. Report 19

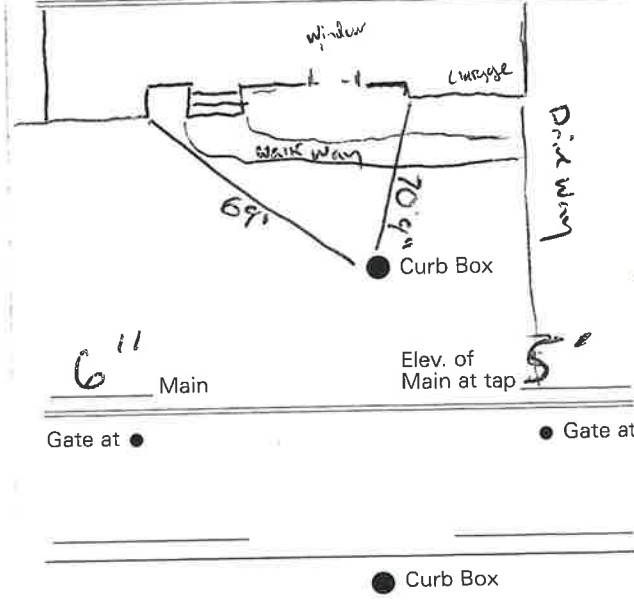

6" Main      Elev. of Main at tap 5'

Gate at ●      ● Gate at

● Curb Box