


LABOR AND MATERIALS

Copper } Connection _____ \$ _____
 Lead }
 Curb } Cock _____ in. _____ \$ _____
 } Valve _____
 } T. S. & V. _____
 Service box { Short 3 1/2 x 4 1/2 }
 Old returned { Long 4 1/2 x 5 1/2 } _____ \$ _____
 20 Ft. 3/4 in. { Copper } Pipe at _____ \$ _____
 } ~~C.I.~~
 } ~~C.I.~~
 Nipples _____ in. at _____ \$ _____
 Bushings _____ to _____ in. at _____ \$ _____
 Red'g }
 Inc'g } Coupl'gs _____ to _____ in. at _____ \$ _____
 Union _____ in. at _____ \$ _____
 Meter _____ in. at _____ \$ _____
 _____ \$ _____
 Compound Joints at _____ \$ _____
 Maintenance Foreman _____ \$ _____
 Hrs. Water Maint. Man—1 at _____ \$ _____
 Hrs. Water Maint. Man—2 at _____ \$ _____
 Hrs. Garage Foreman _____ at _____ \$ _____
 Hrs. Labor— _____ at _____ \$ _____
 Hrs. Compressor at _____ \$ _____
 _____ \$ _____
 Trucking _____ \$ _____
 Pav't Patch _____ \$ _____
 _____ \$ _____
 _____ \$ _____
St. _____
 Pl. _____
 Ave. No. 239

Name of Owner _____
E. SANFORD
 TAX ID # 303.9-18-4

Labor and Mat'l. Report _____ 1990

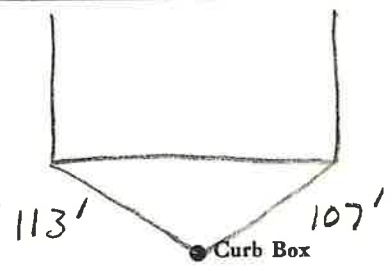

Main _____ Elev. of Main at tap _____
 Gate at • _____ • Gate at _____

 • Curb Box

20' to MAIN
 3/4" COPPER