


LABOR AND MATERIALS

1	Copper	Connection	3/4"	\$
1	Curb	Cock Valve	3/4 in. (MAYKID OYISCA 1)	\$
1	Service box	Short 3/4 x 4 1/2		
	Old returned	Long 4 1/2 x 5 1/2		\$
21	3/4 in.	Copper	Pipe at	\$
	Nipples	in. at		\$
	Bushings	to in. at		\$
	Red'g Inc'g	Coupl'gs to in. at		\$
	Union	in. at		\$
	Meter	in. at		\$
	Lead Joints	at		\$
	Compound Joints	at		\$
	Maintenance Foreman			\$
	Hrs. Water Maint. Man-1	at		\$
	Hrs. Water Maint. Man-2	at		\$
	Hrs. Garage Foreman	at		\$
	Hrs. Labor	at		\$
	Hrs. Compressor	at		\$
	Compensation Ins. at \$	per C		\$
	Trucking			\$
	Pav't Patch			\$
	TAP MADE BY Beecher & Co			\$
	O'head	July-25-1974		\$

SANFORD St. No. 241

Name of Owner
Richard Berke

Labor and Mat'l. Report July 25 1974

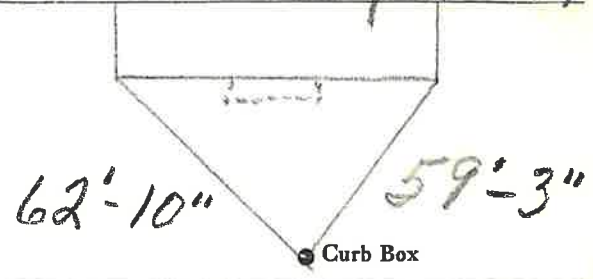

6" Main Elev. of Main at tap 5 1/2'

Gate at TAX ID# 303.9-18-2 Gate at

● Curb Box
21' to MAIN
3/4" copper