

LABOR AND MATERIALS


Copper	} Connection		\$		
Lead			\$		
Curb	} Cock Valve T. S. & V.	} in.	\$		
				} Short 3½ x 4½	\$
Service box	} Buff or Rdway		\$		
Old returned				\$	
Ft.	} Copper G. I. C. I.	} Pipe at	\$		
				} in.	\$
Nipples	in.	at	\$		
Bushings	to	in. at	\$		
Red'g	} Coupl'gs	to	in. at		
Inc'g					\$
Union	in.	at	\$		
Meter	in.	at	\$		
Lead Joints	at		\$		
Compound Joints	at		\$		
Maintenance Foreman	at		\$		
Hrs. Water Maint. Man—1	at		\$		
Hrs. Water Maint. Man—2	at		\$		
Hrs. Garage Foreman	at		\$		
Hrs. Labor—	at		\$		
Hrs. Compressor	at		\$		
Compensation Ins. at \$	per C		\$		
Trucking			\$		
Pav't Patch			\$		
			\$		
			\$		
			\$		
			\$		
O'head			\$		
			\$		

EAST
SANFORD

St.
Pt.
Ave. No. 245

Name of Owner
CROCKWELL

Labor and Mat'l. Report 19

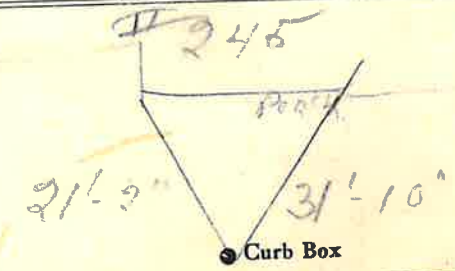

TAX ID # 303.9-18-1.11

Main Elev. of
Main at tap Main at tap

Gate at • • Gate at

• Curb Box