

LABOR AND MATERIALS


1	Copper Lead	Connection	1"	\$
1	Curb	Cock Valve T. S. & V.	1" in.	\$
1	Service box	{ Short 3 1/2 x 4 1/2 Long 4 1/2 x 5 1/2 Buff or Rdway }		\$
	Old returned			\$
2	Ft. 1 in.	Copper G.I. C.I.	Pipe at	\$
	Nipples	in.	at	\$
	Bushings	to	in. at	\$
	Red'g Inc'g	Coupl'gs	to in. at	\$
	Union	in.	at	\$
	Meter	in.	at	\$
	Lead Joints	at		\$
	Compound Joints	at		\$
	Maintenance Foreman			\$
	Hrs. Water Maint. Man-1	at		\$
	Hrs. Water Maint. Man-2	at		\$
	Hrs. Garage Foreman	at		\$
	Hrs. Labor	at		\$
	Hrs. Compressor	at		\$
	Compensation Ins.	at \$	per C	\$
	Trucking			\$
	Pav't Patch			\$
	O'head			\$

1" Tap For 1" Copper Main

St. East Sansard Ave. No. 260

Name of Owner
TAX ID # 303.9-8-19

Labor and Mat'l. Report Aug. 7 1962

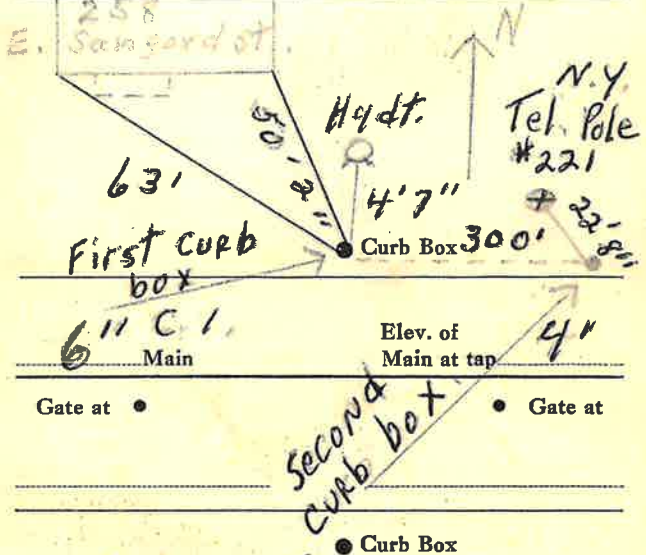

This Tap made
ON Hydt. Lateral
South side of
Hydt. gate

Measured from 258 E. Sansard St

LSM-5C-3-10-61