


Note: Needs to be field verified

**264 East Sanford Street  
785067  
"G.F. Swim & Tennis Club"**

Private water main size 4" CIP

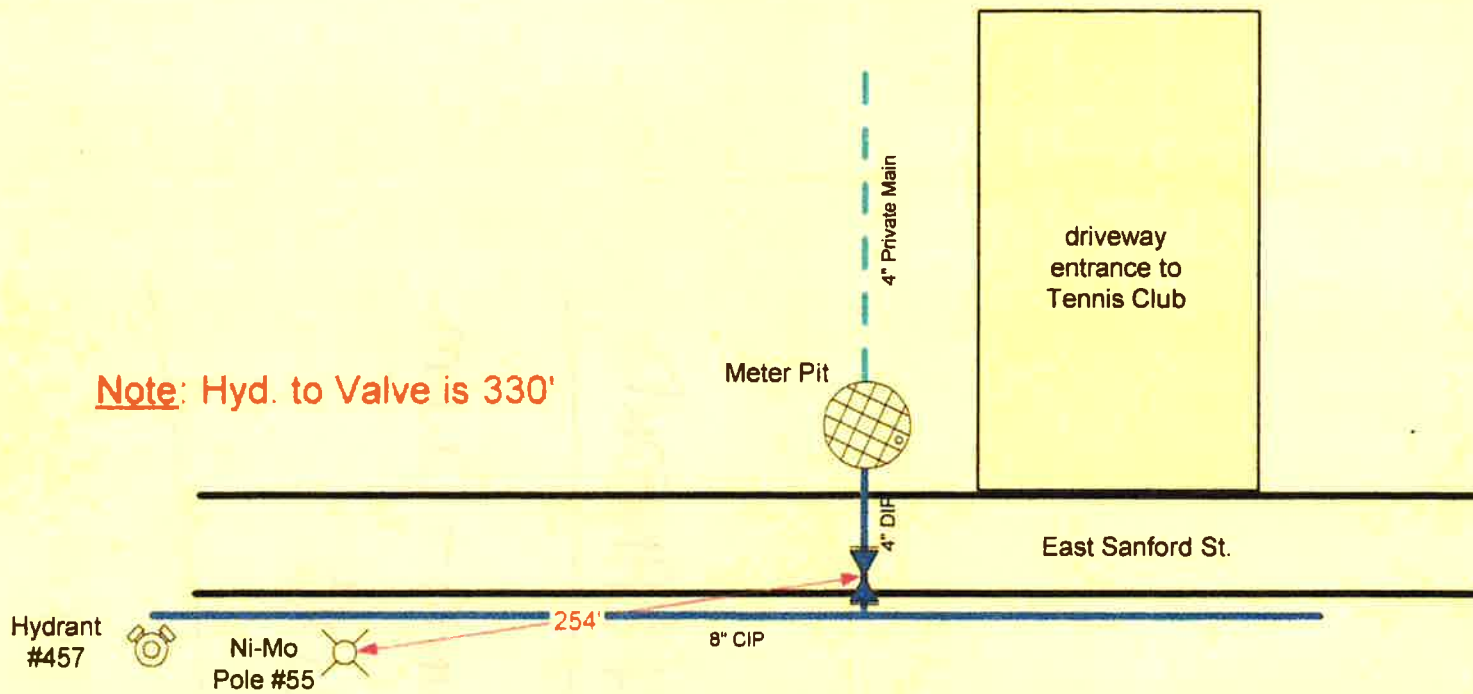

Note: Hyd. to Valve is 330'

driveway entrance to Tennis Club

East Sanford St.

Hydrant #457

Ni-Mo Pole #55

254'

8" CIP

Meter Pit

4" Private Main

4" DIF

264 SANFORD

---

GF TENNIS + SWIM  
CLUB

---

TAX ID # 303.10-1-1