


Labor and Materials

1	Copper	} Connection. <i>3/4"</i>	\$. <i>96</i>
1	Lead			
1	Curb	} Cock Valve T.S.&V. <i>3/4"</i> in	\$. <i>1.33</i>
1	Service Box			
1	Old returned	} Short <i>3 1/2</i> x <i>4 1/2</i> Long <i>4 1/2</i> x <i>5 1/2</i> Buff. or Redway	\$. <i>1.35</i>
10	Ft. <i>3/4"</i> in.			
		} Copper Galv. Iron Cast Iron	Pipe at <i>1.5</i>	\$. <i>1.50</i>
	Nipples			
	Bushings to	in. at	\$.
	Red'g Inc'g	} Couplings to	in. at
	Union			
	Meter in. at	\$.	
	Lbs. Br. Stone	at	\$.	
	Lbs. Sand	at	\$.	
	Bags Cement	at	\$.	
	Paving Brick	} Mack Red Asphalt	at	\$.
	Lead Joints			
	Leadite Joints	at	\$.	
	Hrs. Foreman	at	\$.	
	Hrs. Common Labor	at	\$.	
	Hrs. Common Labor	at	\$.	
	Hrs. Mason	at	\$.	
	Hrs. Masons Helper	at	\$.	
	Hrs. Compressor	at	\$.	
	Compensation Ins	\$.	
	Trucking	\$.	
	Builders Use of Water	\$.	
	Total	\$.....		

133

Labor and Material Report *Nov 2* 19*26*

36 Sanford St 3/4 Tap
GUSTINE

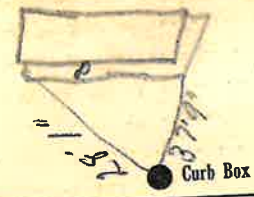

6" Main Elev. of Main at tap *4*

Gate at *TAX* # *302.16-5-31* Gate at

● Curb Box

Old tap shut off
10' to MAIN
3/4" COPPER
22.50