

LABOR AND MATERIALS


1	Copper	{ Connection	3/4"	\$	3.04
1	Lead	{			
		{ Cock	3/4"	\$	3.54
		{ Valve			
		{ T.S. & V.			
1	Service box	{ Short 3 1/2 x 4 1/2		\$	4.70
	Old returned	{ Long 4 1/2 x 5 1/2			
		{ Buff or Rdway			
22	Ft. 3/4" in.	{ Copper		\$	7.70
		{ C.I.			
		{ C.I.			
		{ Pipe at	35	\$	
	Nipples	in. at		\$	
	Bushings	to in. at		\$	
	Red'g	{ Coupl'gs	to in. at	\$	
	Inc'g	{			
	Union	in. at		\$	
	Meter	in. at		\$	
	Lead Joints at			\$	
	Compound Joints at			\$	
1	Hrs. Water Maint. Man-1	at	1.23	\$	1.23
17	Hrs. Water Maint. Man-2	at	1.13	\$	19.21
21	Hrs. Labor	at	1.02	\$	21.42
	Hrs. Labor	at		\$	
	Hrs. Compressor at			\$	
	Compensation Ins. at \$	2.66 per C.		\$	1.17
	Trucking			\$	1.00
	Pav't Patch			\$	1.20
				\$	
				\$	
				\$	
	O'head			\$	
				\$	74.16

Top by Warsinski
June 15-1951

Sanford St. Pl. Ave. No. 37

Name of Owner
Ordway

Labor and Mat'l. Report June 15 1951

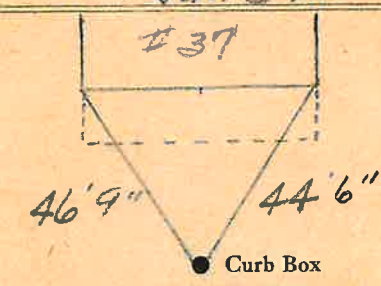

6" Main Elev. of Main at tap 5'

Gate at • Gate at •

TAX ID # 302.16-11-11

22' to main • Curb Box
3/4" COPPER

Old Tap Disconnected