


LABOR AND MATERIALS

1	Copper	Connection	3/4"	\$
1	Lead	Cock	3/4" Or seal.	\$
1	Curb	Valve	3/4" in.	\$
		T.S. & V.		\$
1	Service box	Short 3 1/2 x 4 1/2		\$
	Old returned	Long 4 1/2 x 5 1/2		\$
		Buff or Rdway		\$
22	Ft. 3/4 in.	Copper	Pipe at	\$
		G.I.		\$
		C.I.		\$
	Nipples	in. at		\$
	Bushings	to in. at		\$
	Red'g			\$
	Inc'g	Coupl'gs to in. at		\$
	Union	in. at		\$
	Meter	in. at		\$
	Lead Joints	at		\$
	Compound Joints	at		\$
	Maintenance Foreman			\$
	Hrs. Water Maint. Man-1	at		\$
	Hrs. Water Maint. Man-2	at		\$
	Hrs. Garage Foreman	at		\$
	Hrs. Labor	at		\$
	Hrs. Compressor	at		\$
	Compensation Ins. at \$	per C		\$
	Trucking			\$
	Pav't Patch			\$
	O'head			\$
	Tap by Gistard & Co.			\$
	12-20-66			\$

St. Sanford
 -Pl. Ave. No. 23

Name of Owner Galosus.

Labor and Mat'l. Report Dec 20 1966

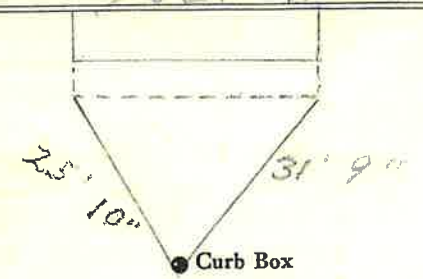

6" Main Elev. of Main at tap 6'
 Gate at • Gate at •

TAX ID # 302.16-11-17

• Curb Box
 22' to MAIN
 3/4" COPPER