

LABOR AND MATERIALS


1	Copper	Connection	3/4"	\$	_____
1	Lead	Cock	3/4" in.	\$	_____
1	Curb	Valve	3/4" in.	\$	_____
		T. S. & V.		\$	_____
1	Service box	Short 3 1/2 x 4 1/2		\$	_____
	Old returned	Long 4 1/2 x 5 1/2		\$	_____
		Buff or Rdway		\$	_____
23	Ft.	3/4" in.	Copper	Pipe at	\$ _____
			G.I.		\$ _____
			G.I.		\$ _____
	Nipples	in.	at	\$	_____
	Bushings	to	in.	at	\$ _____
	Red'g	Coupl'gs	to	in.	at
	Inc'g				\$ _____
	Union	in.	at	\$	_____
	Meter	in.	at	\$	_____
	Lead Joints	at		\$	_____
	Compound Joints	at		\$	_____
	Maintenance Foreman			\$	_____
	Hrs. Water Maint. Man-1	at		\$	_____
	Hrs. Water Maint. Man-2	at		\$	_____
	Hrs. Garage Foreman	at		\$	_____
	Hrs. Labor	at		\$	_____
	Hrs. Compressor	at		\$	_____
	Compensation Ins.	at \$	per C	\$	_____
	Trucking			\$	_____
	Pav't Patch			\$	_____
	O'head			\$	_____

Tap by Giffard & Co. 7-13-61

St. ~~Pl.~~ Sanford Ave. No. 45

Name of Owner Bartholomew Girard

Labor and Mat'l. Report July 13 19 61

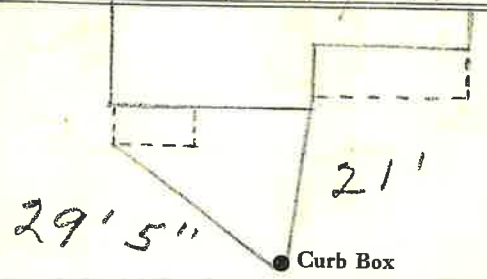

6" Main Elev. of Main at tap 3 1/2'

Gate at • • Gate at

TAX ID # 302.16-12-20

• Curb Box

23' to main
3/4" COPPER