

Labor and Materials

1	Copper	} Connection	3/4"		\$	
	Lead					
1	Curb	} Cock Valve	3/4	in.	\$	
						T.S. & V.
1	Service Box	} Short 3 1/2 x 4 1/2			\$	
	Old returned					Long 4 1/2 x 5 1/2
9	Ft. 3/4	} Copper Galv. Iron	in.	Pipe at	\$	
						Cast Iron
	Nipples					
1	Bushings		3/4	to 1/2		
	Red'g Inc'g					
	Union					
	Meter					
	Lbs Br. Stone					
	Lbs. Sand					
	Bags Cement					
	Paving Brick	} Mack Red Asphalt				
	Lead Joints					
	Leadite Joints					
	Hrs. Foreman					
	Hrs. Common Labor					
	Hrs. Mason					
	Hrs Mason's Helper					
	Hrs. Compressor					
	Compensation Ins.					
	Trucking					
	Builders' Use of Water					
	Total				\$	


Labor and Material Report

June 18

19 20

25

~~38~~ SANFORD ST
46

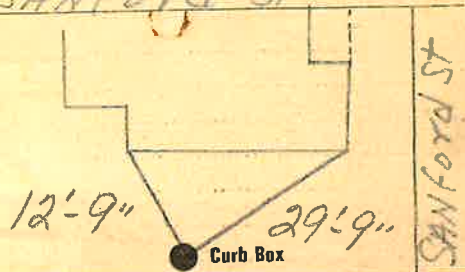

SMITH ST

4 Main

Elev. of Main at tap

51

Gate at

TAX ID # 302.110-6-25

Gate at

Curb Box

TAP ON SMITH ST

9' to MAIN

3/4" GAL.