


LABOR AND MATERIALS

1 Copper } Connection 3/4" \$ _____
 Lead }
 1 Curb } Cock } 3/4 in. ORISEAL
 Valve }
 T.S. & V. }
 1 Service box } Short 3 1/2 x 4 1/2 }
 Old returned } Long 4 1/2 x 5 1/2 } \$ _____
 Buff or Rdway }
 12 Ft. 3/4" in. } Copper } Pipe at _____ \$ _____
 } G. I. }
 } C. I. }
 Nipples _____ in. at _____ \$ _____
 Bushings _____ to _____ in. at _____ \$ _____
 Red'g }
 Inc'g } Coupl'gs _____ to _____ in. at _____ \$ _____
 Union _____ in. at _____ \$ _____
 Meter _____ in. at _____ \$ _____
 Lead Joints at _____ \$ _____
 Compound Joints at _____ \$ _____
 Maintenance Foreman _____ \$ _____
 Hrs. Water Maint. Man—1 at _____ \$ _____
 Hrs. Water Maint. Man—2 at _____ \$ _____
 Hrs. Garage Foreman _____ at _____ \$ _____
 Hrs. Labor _____ at _____ \$ _____
 Hrs. Compressor at _____ \$ _____
 Compensation Ins. at \$ _____ per C _____ \$ _____
 Trucking _____ \$ _____
 Pav't Patch _____ \$ _____
 TAP MADE BY GIFFORD _____ \$ _____
 40 9-7-65 _____ \$ _____
 O'head _____ \$ _____
 _____ \$ _____

St. _____
 Pl. _____
 Ave. No. 54

Name of Owner
DOCTORS OFFICES

Labor and Mat'l. Report NOV 20 1969

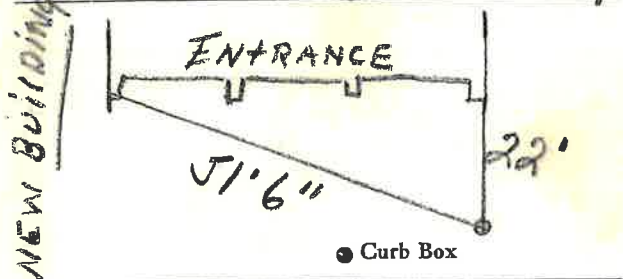

TAX ID # 302.16-6-27
 Elev. of Main _____
 Main at tap _____

Gate at • 12' to main • Gate at
3/4" COPPER

MEASURED IN THIS DATE
NOV-20-1969
 By LAREAU